


EXPERIENCE THE NEW BLUE HILL PLAZA


ONE BLUE HILL PLAZA

PARTIAL 10TH FLOOR - 1,254 SQ. FT.

AS-BUILT PLAN

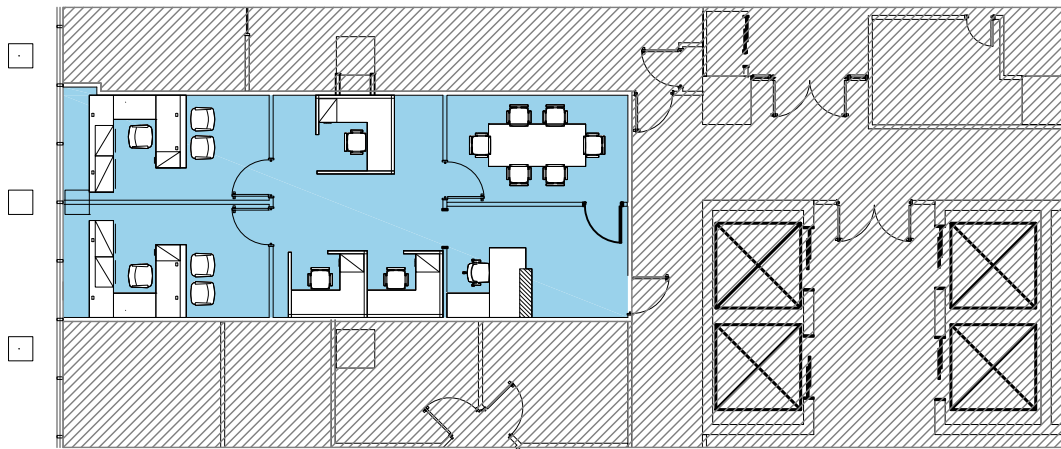

LEGEND	
ROOM TYPE	COUNT
OFFICES	2
RECEPTION	1
CUBICLES 6'x6'	1
CUBICLES 5'x6'	2
CONFERENCE - SEATS 6	1

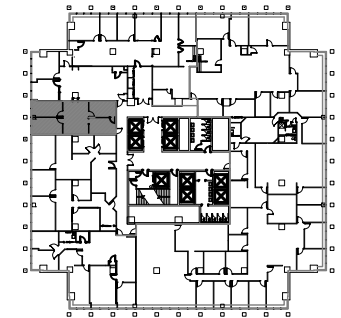

Scale: N.T.S. 

A PROPERTY OF

GSNY

WWW.BLUEHILLPLAZA.COM

CBRE

JAMES B. TULLY
Executive Vice President
james.tully@cbre.com
201.712.5804

SEAN MORLEY
First Vice President
sean.morley@cbre.com
201.712.5662

FRED SULLIVAN
Associate
fred.sullivan@cbre.com
201.712.5894