



EXPERIENCE THE NEW BLUE HILL PLAZA

TWO BLUE HILL PLAZA PARTIAL 3RD FLOOR - 8,690 SQ. FT. AS-BUILT PLAN

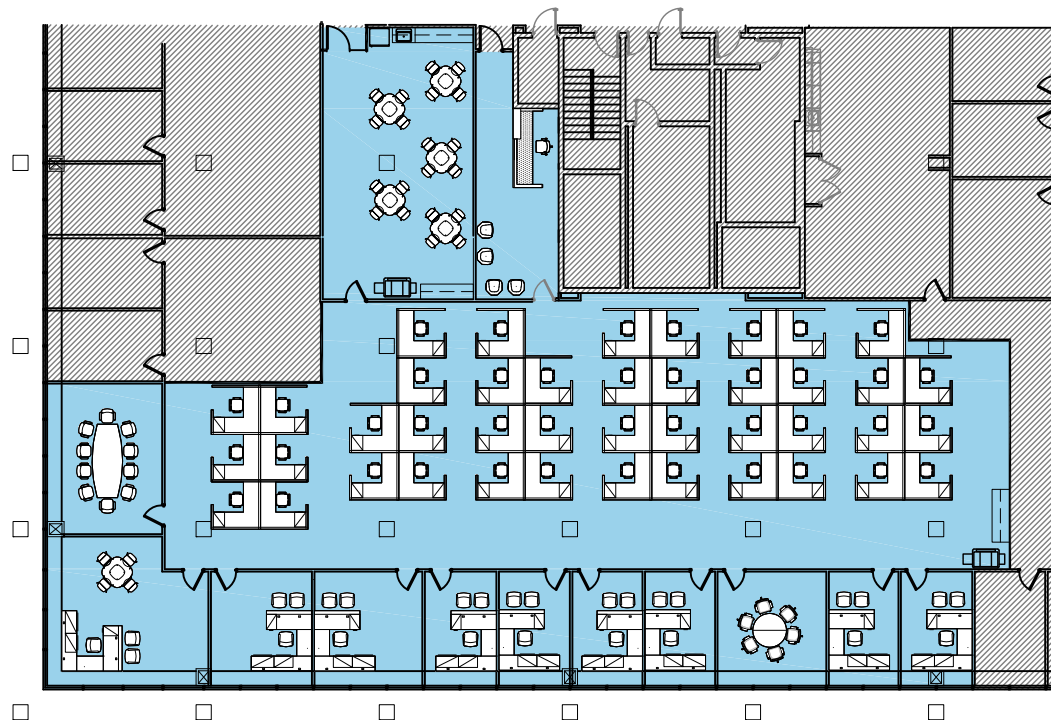

LEGEND	
ROOM TYPE	COUNT
OFFICES	9
PRINT/COPY	2
CUBICLES 6'x6"	42
CONFERENCE - SEATS 10	1
Huddle - SEATS 6	1
CAFE - SEATS 20	1
RECEPTION	1

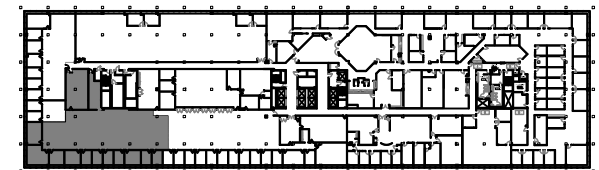

Scale: N.T.S.

A PROPERTY OF

GSNY

WWW.BLUEHILLPLAZA.COM

CBRE

JAMES B. TULLY
Executive Vice President
james.tully@cbre.com
201.712.5804

SEAN MORLEY
First Vice President
sean.morley@cbre.com
201.712.5662

FRED SULLIVAN
Associate
fred.sullivan@cbre.com
201.712.5894