



EXPERIENCE THE NEW BLUE HILL PLAZA

ONE BLUE HILL PLAZA PARTIAL 6TH FLOOR - 5,500 SQ. FT. AS-BUILT PLAN

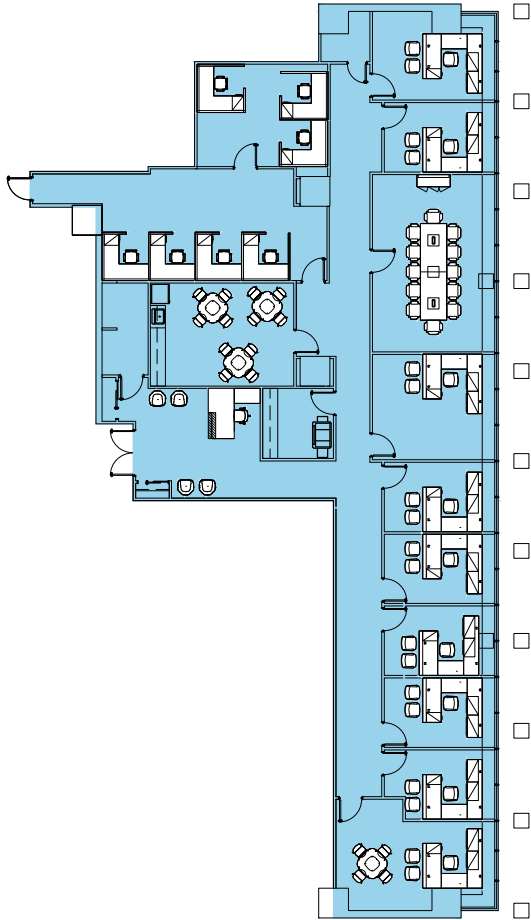

LEGEND	
ROOM TYPE	COUNT
OFFICES	9
RECEPTION	1
CUBICLES 6'x6'	7
CAFE - SEATS 12	1
COAT CLOSET	2
PRINT/COPY	1
CONFERENCE - SEATS 12	1
IT	1
STORAGE	1

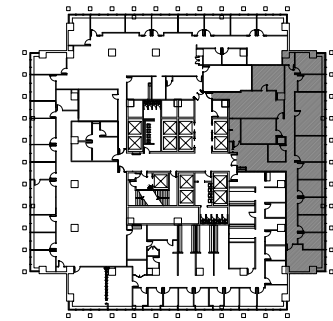

Scale: N.T.S 

WWW.BLUEHILLPLAZA.COM



JAMES B. TULLY
Executive Vice President
james.tully@cbre.com
201.712.5804

SEAN MORLEY
First Vice President
sean.morley@cbre.com
201.712.5662

FRED SULLIVAN
Associate
fred.sullivan@cbre.com
201.712.5894

