



EXPERIENCE THE NEW BLUE HILL PLAZA

ONE BLUE HILL PLAZA PARTIAL 3RD FLOOR - 3,000 SQ. FT. AS-BUILT PLAN

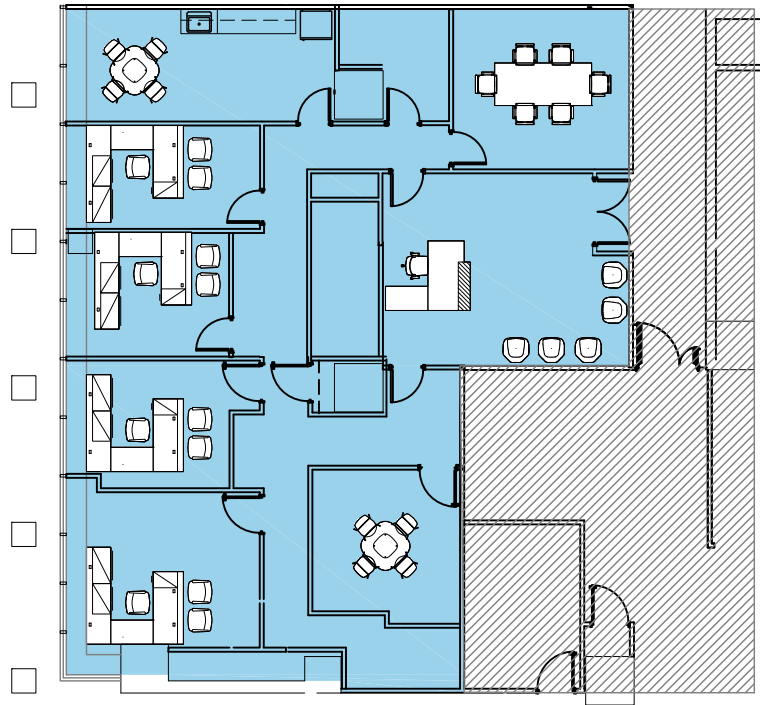

LEGEND	
ROOM TYPE	COUNT
OFFICES	4
RECEPTION	1
CONFERENCE - SEATS 6	1
HUDDLE - SEATS 4	1
PRINT/COPY	1
CAFE - SEATS 4	1
IT	1

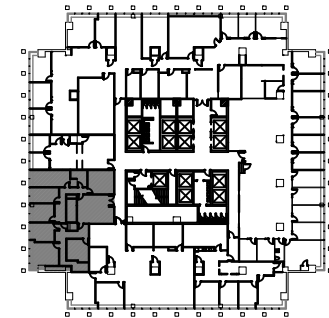

Scale: N.T.S. 

A PROPERTY OF

GSNY

WWW.BLUEHILLPLAZA.COM

CBRE

JAMES B. TULLY
Executive Vice President
james.tully@cbre.com
201.712.5804

SEAN MORLEY
First Vice President
sean.morley@cbre.com
201.712.5662

FRED SULLIVAN
Associate
fred.sullivan@cbre.com
201.712.5894