



# EXPERIENCE THE NEW BLUE HILL PLAZA

## ONE BLUE HILL PLAZA PARTIAL 11TH FLOOR - 6,038 SQ. FT. AS-BUILT PLAN

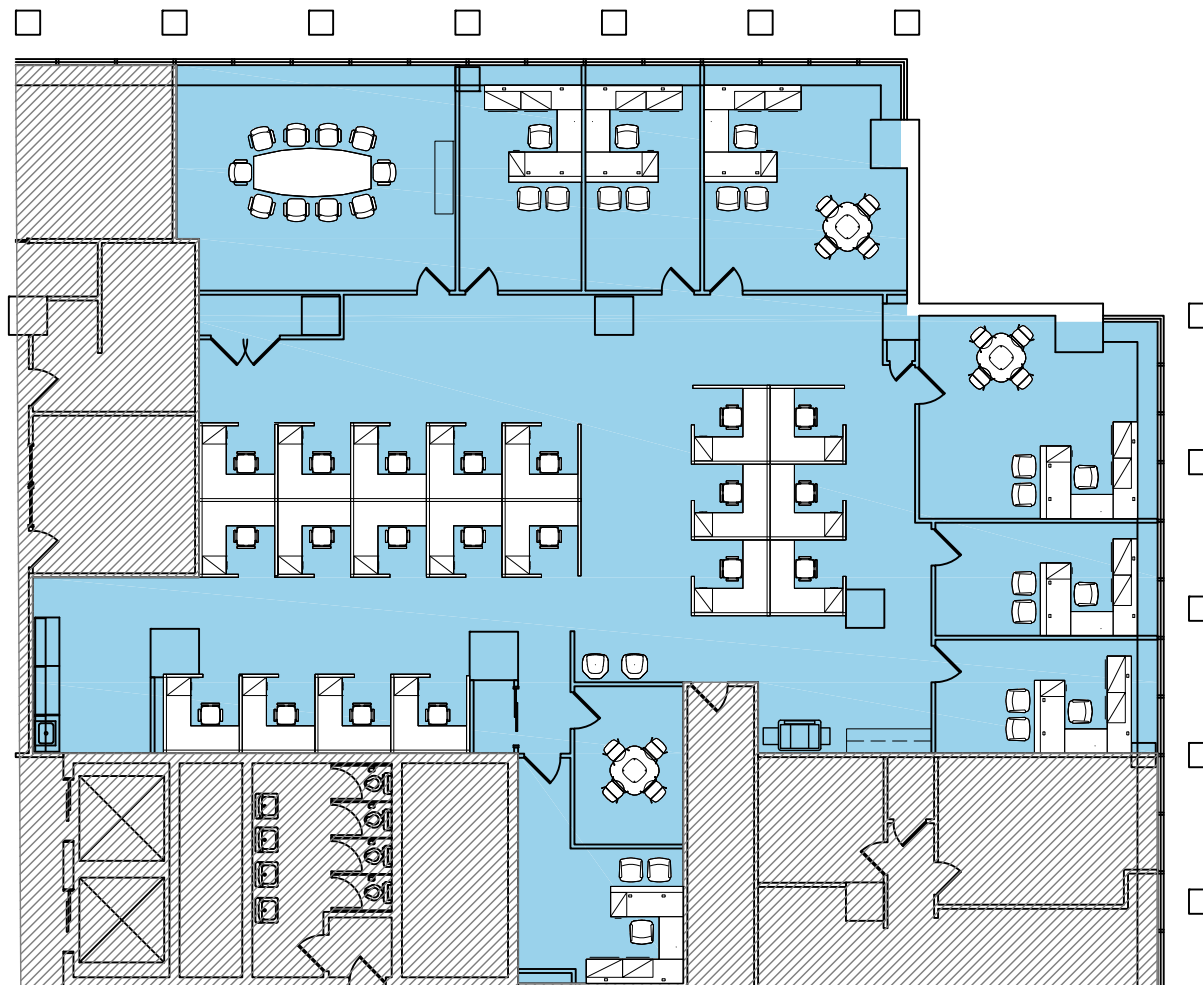

| LEGEND                |       |
|-----------------------|-------|
| ROOM TYPE             | COUNT |
| OFFICES               | 7     |
| RECEPTION             | 1     |
| CUBICLES 6'x6'        | 20    |
| CAFE                  | 1     |
| Huddle - SEATS 4      | 1     |
| PRINT/COPY            | 1     |
| CONFERENCE - SEATS 10 | 1     |

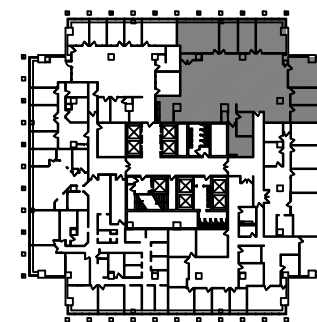

Scale: N.T.S



A PROPERTY OF

GSNY

WWW.BLUEHILLPLAZA.COM

**CBRE**

**JAMES B. TULLY**  
Executive Vice President  
[james.tully@cbre.com](mailto:james.tully@cbre.com)  
201.712.5804

**SEAN MORLEY**  
First Vice President  
[sean.morley@cbre.com](mailto:sean.morley@cbre.com)  
201.712.5662

**FRED SULLIVAN**  
Associate  
[fred.sullivan@cbre.com](mailto:fred.sullivan@cbre.com)  
201.712.5894